




C. Earl Hunter, Commissioner

Promoting and protecting the health of the public and the environment.

PUBLIC NOTICE AMENDMENT REQUEST

The permittee for P/N# **OCRM-01-321-R**, Robert W Holmes and Michael Roe, has requested an after-the-fact amendment to that issued permit. The after-the-fact amendment seeks to keep the following configuration on a joint-use dock: 4' x 235' walkway leading to an 8' x 10' pierhead. Ebbside of the pierhead, a ramp is accessing a 5' x 9' float and 10' x 18' floating jet dock. Floodside of the pierhead, a ramp accesses an 8' x 10' floating dock and 12' x 12' four-pile boatlift. This structure is located on and adjacent to Darrell Creek at 310 and 314 Commonwealth Road, Darrell Creek Subdivision, Mount Pleasant, Charleston County, South Carolina.

Written comments will be received on this amendment request until July 10, 2006 at the address listed below. For further information please contact the project manager, Tess Rodgers, 843-744-5838.

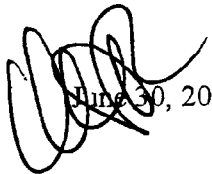
June 30, 2006


SOUTH CAROLINA DEPARTMENT OF HEALTH AND ENVIRONMENTAL CONTROL

Ocean and Coastal Resource Management

Charleston Office • 1362 McMillan Avenue, Suite 400 • Charleston, SC 29405

Phone: 843-744-5838 • Fax: 843-744-5847 • www.scdhec.gov

CRITICAL LINE SHOWN IS PER RECORDED PLAT

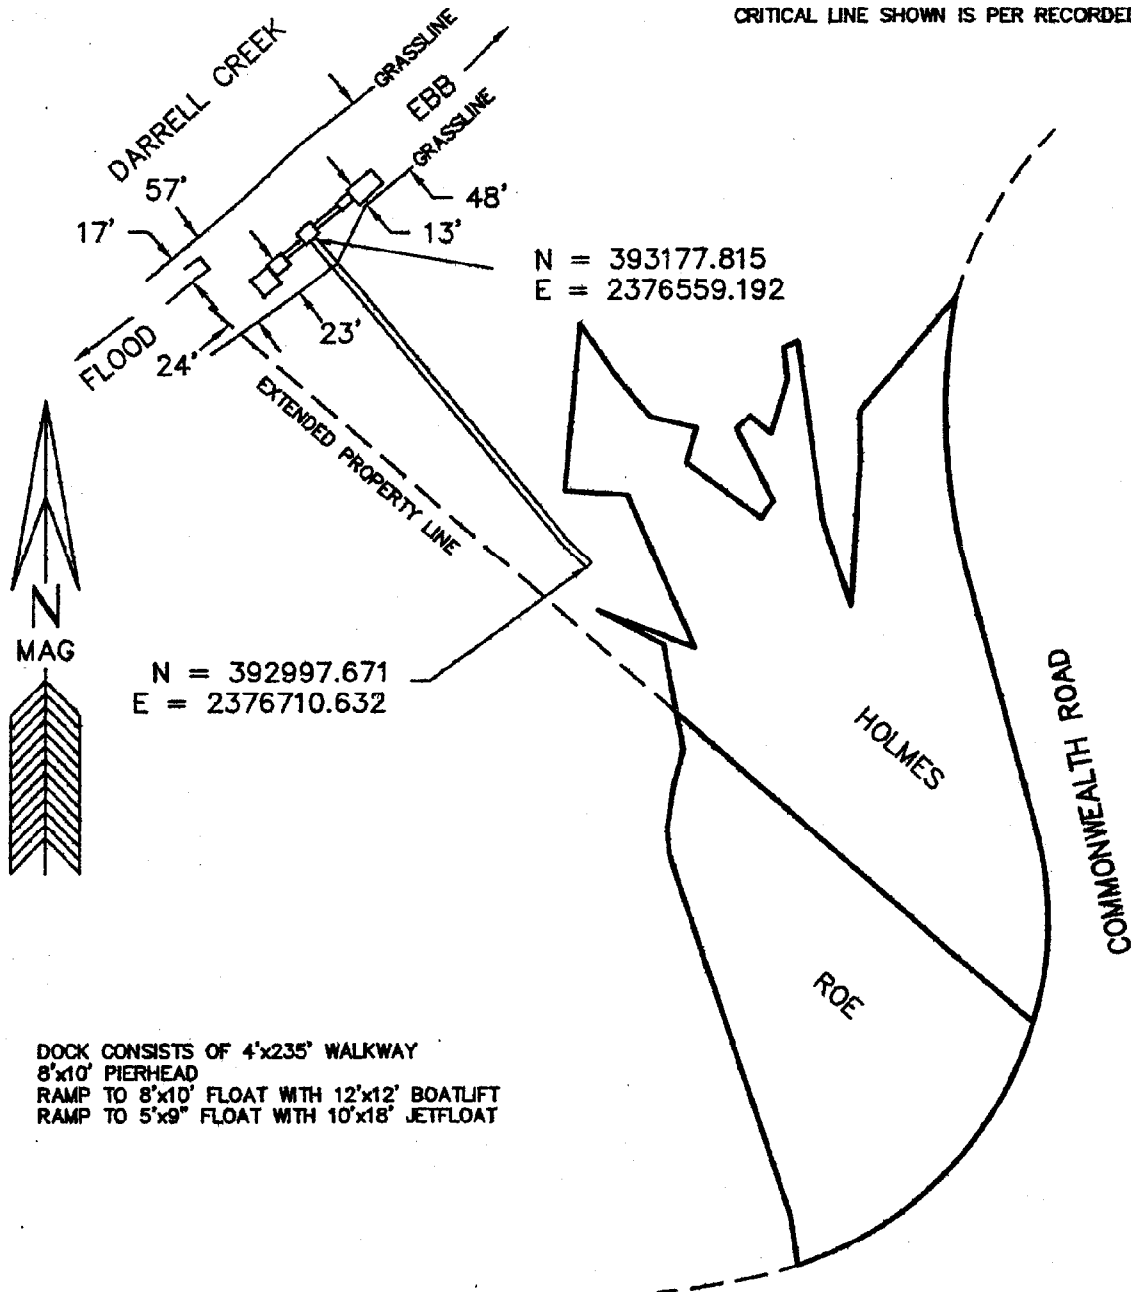


OCRIM-01-321-R
AFTER THE PACT Amendment

HOLMES/ROE
310/314 COMMONWEALTH RD
DARRELL CREEK
TOWN OF MOUNT PLEASANT
CHARLESTON COUNTY
TMS# 596-08-00-150 & 151
DARRELL CREEK

DOCK
ASBUILT

DATE: MAY 15, 2006
SCALE: 1" = 100'

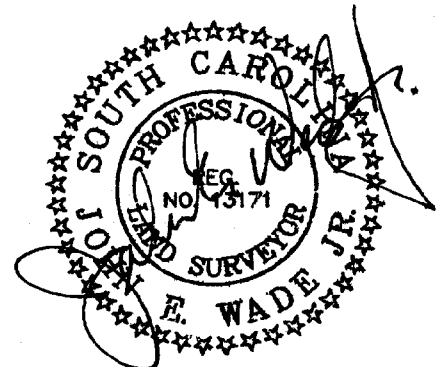

FILE #097-06

100 0 100